


P:\00---\00159\DWG\PERMIT\ROOSEVELT DR CRD\_1.DWG 07-22-16 1:45:18 PM - LAYOUT AS-BUILT

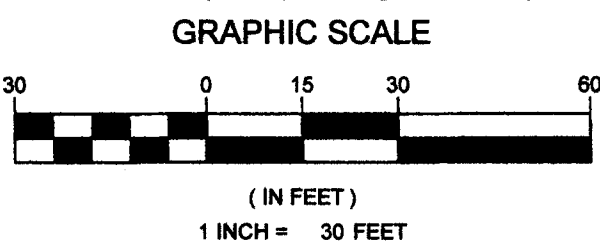

## ABBREVIATIONS

EL	ELEVATION	N/F	NOW OR FORMERLY
INV	INVERT	BCB	BITUMINOUS CONCRETE BERM
FT	FEET	PCT	POINT OF TANGENCY
SF	SQUARE FEET	PC	POINT OF CURVATURE
AC	ACRES	SAA	SOIL ABSORPTION AREA
R	RADIUS	BDR	BEDROOM
BT	BOTTOM	GR	GARAGE
BIT	BITUMINOUS	FDM	FOUNDATION
CONC	CONCRETE	BSMT	BASEMENT
BM	BENCHMARK	UP	UTILITY POLE

**DRAWING ISSUED FOR:**

☐ CONCEPT      ☐ CONSTRUCTION

☐ PERMIT          ☒ CONSTRUCTION  
RECORD

THIS DRAWING IS INTENDED TO SHOW CONDITIONS AFTER COMPLETION OF CONSTRUCTION AS RECORDED BY CONTRACTOR, OWNER REPRESENTATIVE, AND/OR ENGINEER. LOCATION OF IMPROVEMENTS SHOWN HEREON IS APPROXIMATE. THIS DRAWING IS NOT INTENDED TO SHOW EXACT LOCATIONS AND DETAILS OF ALL COMPLETED IMPROVEMENTS.

PER 250 CMR 5.03(13), THE FOLLOWING ARE EXCLUDED FROM THE PROFESSION ENGINEER'S RESPONSIBILITY: ALL BOUNDARY INFORMATION; ACTUAL LOCATION UNDERGROUND UTILITY LINES, FOUNDATIONS AND OTHER SUBSURFACE FEATURES. SEE CONSTRUCTION RECORD NOTES.

1	07/22/16	MCL	BDR	MODIFICATION TO BASIN #2 AND OUTLET
NO.	DATE	BY	APP.	REVISION DESCRIPTION

**GPR** Engineering Solutions  
for Land & Structures

**GOLDSMITH, PREST & RINGWALL, INC.**

39 MAIN STREET, SUITE 301, AYER, MA 01432

CIVIL ENGINEERING • LAND SURVEYING • LAND PLANNING

VOICE: 978.772.1590 FAX: 978.772.1591

[www.gpr-inc.com](http://www.gpr-inc.com)

RESIDENTIAL COMPOUND

INTERIM CONSTRUCTION RECORD

ROOSEVELT DRIVE  
ACTON, MA

PREPARED FOR:  
GUIDO GAGLIANO  
17 WASHINGTON DRIVE  
ACTON, MA 01720

DES. BY: MEH	DATE: DECEMBER 2015	JOB 00159A	C4.1
CHK BY: BDR			